


Found, 2 1/2" pipe with cap marked R.E. Fonger R.L.S. 4235

SURVEYOR'S CERTIFICATE
 I, Lenard D. Smith, a Professional Land Surveyor registered in the State of Nevada, certify that:
 1. This plat represents the results of a survey conducted under my direct supervision at the instance of J. Steven Thiriot.
 2. The lands surveyed lie within Section 18, T.2S., R.68E., M.D.M. The survey was completed on December 15/1998.
 3. This plat complies with the applicable state statutes and any local ordinances in effect on the date that the survey was completed. The survey was conducted in accordance with Chap. 625 of the Nev. Administrative Code.
 4. The monuments depicted on the plat are of the character shown, occupy the positions indicated and are of sufficient number and durability.
 Lenard D. Smith, P.L.S. 12751

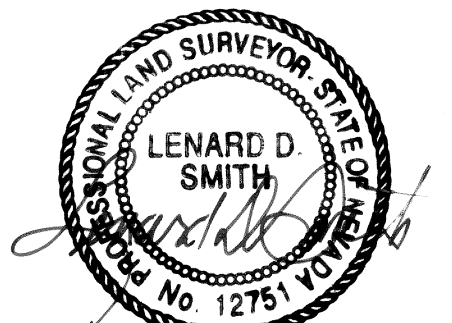

OWNER'S CERTIFICATE
 We, Co-Trustees of the Dean P and Florence W. Thiriot Trust do hereby certify that we are the owners of the lands depicted on this plat and have requested Lenard D. Smith, a Professional Land Surveyor to prepare this plat for recordation.
 SURVIVING GRANTEE: Florence W. Thiriot
 CO-TRUSTEES: Florence W. Thiriot, Joan T. Yockey
 J. Steven Thiriot
 Notary Public


ACKNOWLEDGEMENT
 STATE OF UTAH } ss
 COUNTY OF SALT LAKE }
 I certify that Florence W. Thiriot, J. Steven Thiriot and Joan T. Yockey appeared before me, a Notary Public this 12 day of December, 1998, and executed the above Owner's Certificate freely and voluntarily.
 Notary Public

LEGEND
 SECTION CORNERS
 Found Set with 5/8" rebar Not found Set with 5/8" rebar and aluminum cap
 stamped L. SMITH PLS 12751 & Ident. nor set

BASIS OF BEARINGS
 The Range line between Sections 25 & 30 and 24 & 19, T.2S., R.67 & 68E., M.D.M. as recorded on Parcel Map Plat Book B, Page 173 by Carl Peterson, PLS 6204 and unrecorded map of Record Survey by L. Smith PLS 12751 for Wayne Turner.

MAP REFERENCES
 G.L.O. Survey Notes, by Monroe & Bateman and B.L.M. Survey Notes by Neil Forsyth.

SCALE: 1" = 300'
 300 200 100 0 300 600 900

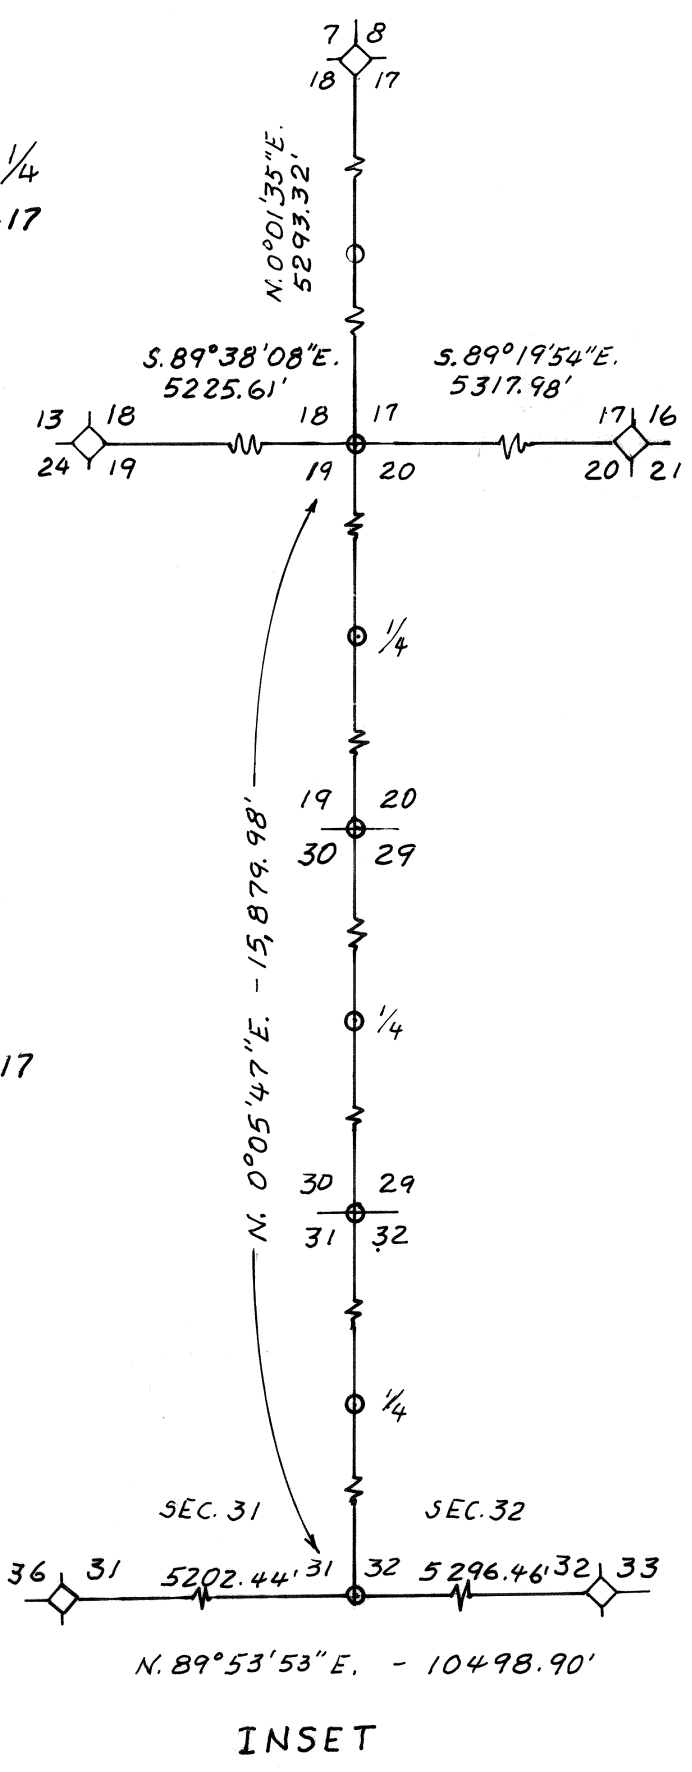

RECORDER'S CERTIFICATE
 File No. 113043
 Filed at the request of J. Steven Thiriot
 Filed Plat Book B, Page 173
 Lincoln County Records
 Date Dec 16, 1998 at 1:55pm
 Yuriko Setzer, Recorder
 By Felicia Boucher, Deputy

RECORD OF SURVEY
 FOR THE DEAN P. & FLORENCE W. THIRIOT TRUST
 IN LOT 3, NE 1/4 SW 1/4, SE 1/4 NW 1/4, AND W 1/2 SW 1/4 NE 1/4 SECTION 18, T.2S., R.68E., M.D.M., LINCOLN COUNTY, NEVADA