



SURVEYOR'S CERTIFICATE

I, Lenard D. Smith, a Professional Land Surveyor registered in the State of Nevada, certify that:

1. This plat represents the results of a survey conducted under my supervision at the instance of Edward & Linda Wright.
2. The land surveyed lies within Section 22, T 1 N., R. 67 E., M.D.M., Townsite of Pioche, Lincoln County, Nevada.
3. The survey was completed on June 13, 2005.
4. This plat complies with applicable statutes of this state and any local ordinances in effect on the date that the survey was completed, and the survey was conducted in accordance with Chapter 625 of the Nevada Administrative Code.
5. The monuments depicted on the plat are of the character shown, occupy the positions indicated, and are of sufficient durability.

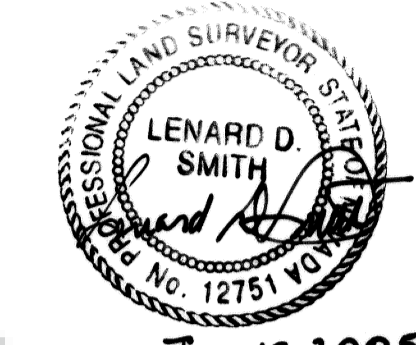

Lenard D. Smith P.L.S. 12751
 June 17, 2005
 Exp. 6/30/06

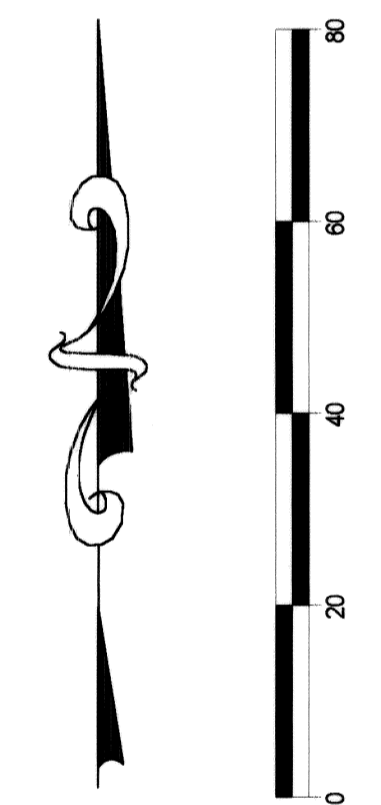

SCALE: 1" = 20'

LEGEND

- Set #5 rebar & plastic cap stamped L SMITH PLS 12751
- Property boundary
- Street centerline
- - - Buildings
- - - Parking

BASIS OF BEARINGS

The basis of bearings is the east line of the southeast quarter of Section 22, T. 1 N., R. 67 E., M.D.M. shown as N 01° 46' 06" E, in the Bulloch Bros. Survey of the Townsite of Pioche, Plat Book A, Page 382 (15 sheets) of Lincoln County, Nevada Records.

BASIS OF BEARINGS

MAP REFERENCES AND NOTES

This map was constructed using BULLOCK BROTHERS INC., map of the TOWN OF PIOCHE.
 Recorded in PLAT BOOK B, PAGE 382 (15 sheets) of Lincoln County, Nevada Records.
 Deed in OFFICIAL RECORDS BOOK 74, PAGE 86.

RECORDER'S CERTIFICATE

File number 124764
 Recorded at the request of Lenard D. Smith
 Filed in Plat Book 6, Page 123
 This 17 day of June, 2005
 at 3:55 p.m.
 Leslie Boucher, Recorder
 By: Angie Flynn Deputy
pd \$21.00

APN # 01-095-01

RECORD OF SURVEY

SHOWING LOTS A AND B OF BLOCK 25 of the
 Townsite of Pioche, Lincoln County, Nevada

FOR: Edward & Linda Wright

SECTION 22, T 1 N., R. 67 E., M.D.M.

Lenard D. Smith
LAND SURVEY
 509 main street
 P.O. Box 443
 Caliente, Nevada 89008
 Phone/Fax 775 726 3365