


Boundary Line Adjustment

In Section 14, Township 5 South, Range 60 East, Mount Diablo Meridian
 APN ~~011-100-03~~ and 011-100-04

011-100-16
 011-100-18

DOC # 0146115
 08/20/2014 08:57 AM
Official Record
 Recorded/Required By:
 LENARD SMITH LAND SURVEY
 Lincoln County - NV
 Leslie Boucher - Recorder
 Fee: \$21.00 Page 1 of 1
 RPT1 Recorded By: RE
 Book - D Page - 0125
 0146115

SURVEYOR'S CERTIFICATE
 I, Lenard D. Smith, a Professional Land Surveyor licensed in the State of Nevada certify that:
 1. This plat represents the results of a survey conducted under my direct supervision at the instance of Dan Stewart
 2. I have performed a field survey sufficient to locate and identify properly the proposed boundary line adjustment
 3. The land surveyed lies in Section 14, Township 5 South, Range 60 East M.D.M. in Lincoln County, Nevada
 4. The monuments depicted on the plat are of the character shown, occupy the positions indicated, and are of sufficient number and durability. All corners and angle points of the adjusted boundary line have been defined by monuments or will otherwise be defined on a document of record as required by NRS 225.340.
 5. The map is not in conflict with the provision of NRS 278.010 to 278.630, inclusive

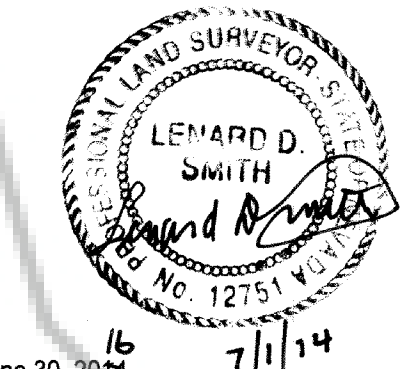


Lenard D. Smith PLS 12751, Exp. June 30, 2014

OWNER'S CERTIFICATE

We certify that we are the owner's of the lands as shown on this map. We have examined the plat and approve and authorize the recording thereof. We agree to execute the required documents creating any easement which is shown. We agree to execute the required documents abandoning any existing easement pursuant to the provisions of NRS 278.010 to 278.630, inclusive. All property taxes on the land for the fiscal year have been paid. Any lender with an unpaid account for the payment of taxes has been notified of the adjustment of the boundary line or the transfer of the land.


[Signature] - TREASURER - 07/07/14
 Nevada Rock and Sand by Dan Stewart Title Date
[Signature] V. Pres. 10 Jul 2014
 Farmland Reserve, Inc. by Title Date

ACKNOWLEDGEMENT

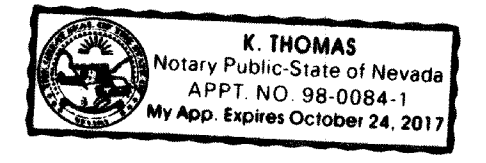

STATE OF NEVADA) ss
 COUNTY OF Clark)
 This instrument was acknowledged before me on 07/07/2014 by Dan Stewart, freely and voluntarily for the purposes stated.
[Signature] My commission expires 10/24/2017
 Notary public

ACKNOWLEDGEMENT

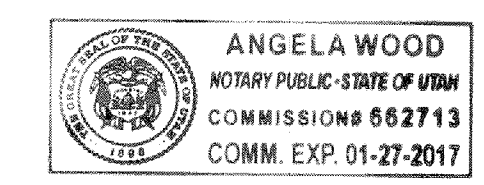

STATE OF NEVADA) ss
 COUNTY OF LINCOLN)
 This instrument was acknowledged before me on July 10, 2014 by Warren H. Peterson, freely and voluntarily for the purposes stated.
[Signature] My commission expires 01/27/2017
 Notary public

PLANNING COMMISSION


This is to certify that the zoning and comprehensive planning, of the County of Lincoln, Nevada did approve for the purpose of land division and do hereby accept in behalf of the public, this plat and any easements offered for public use.
[Signature] 07-10-14
 Lincoln County Planning Commission Date

LINCOLN COUNTY TREASURER APPROVAL

Pursuant to NRS 278.468 I hereby certify that the taxes for the fiscal year 2013-2014 on Assessor Parcel Numbers ~~011-100-03~~ and 011-100-04 are paid in full.
 011-100-16 & 18
[Signature] 8/20/14
 Lincoln County Treasurer and Ex-officio Tax Receiver Date

LINCOLN COUNTY RECORDER APPROVAL

Pursuant to NRS 278.467 and 278.468, I hereby certify that this map was recorded within 1 year of the Lincoln County Planning Commission approval, the map is in an acceptable form for recording, the treasurer signature date matches the recorder date and that all fees have been paid for the recording of this document.
[Signature] 8-20-14
 Lincoln County Recorder Date

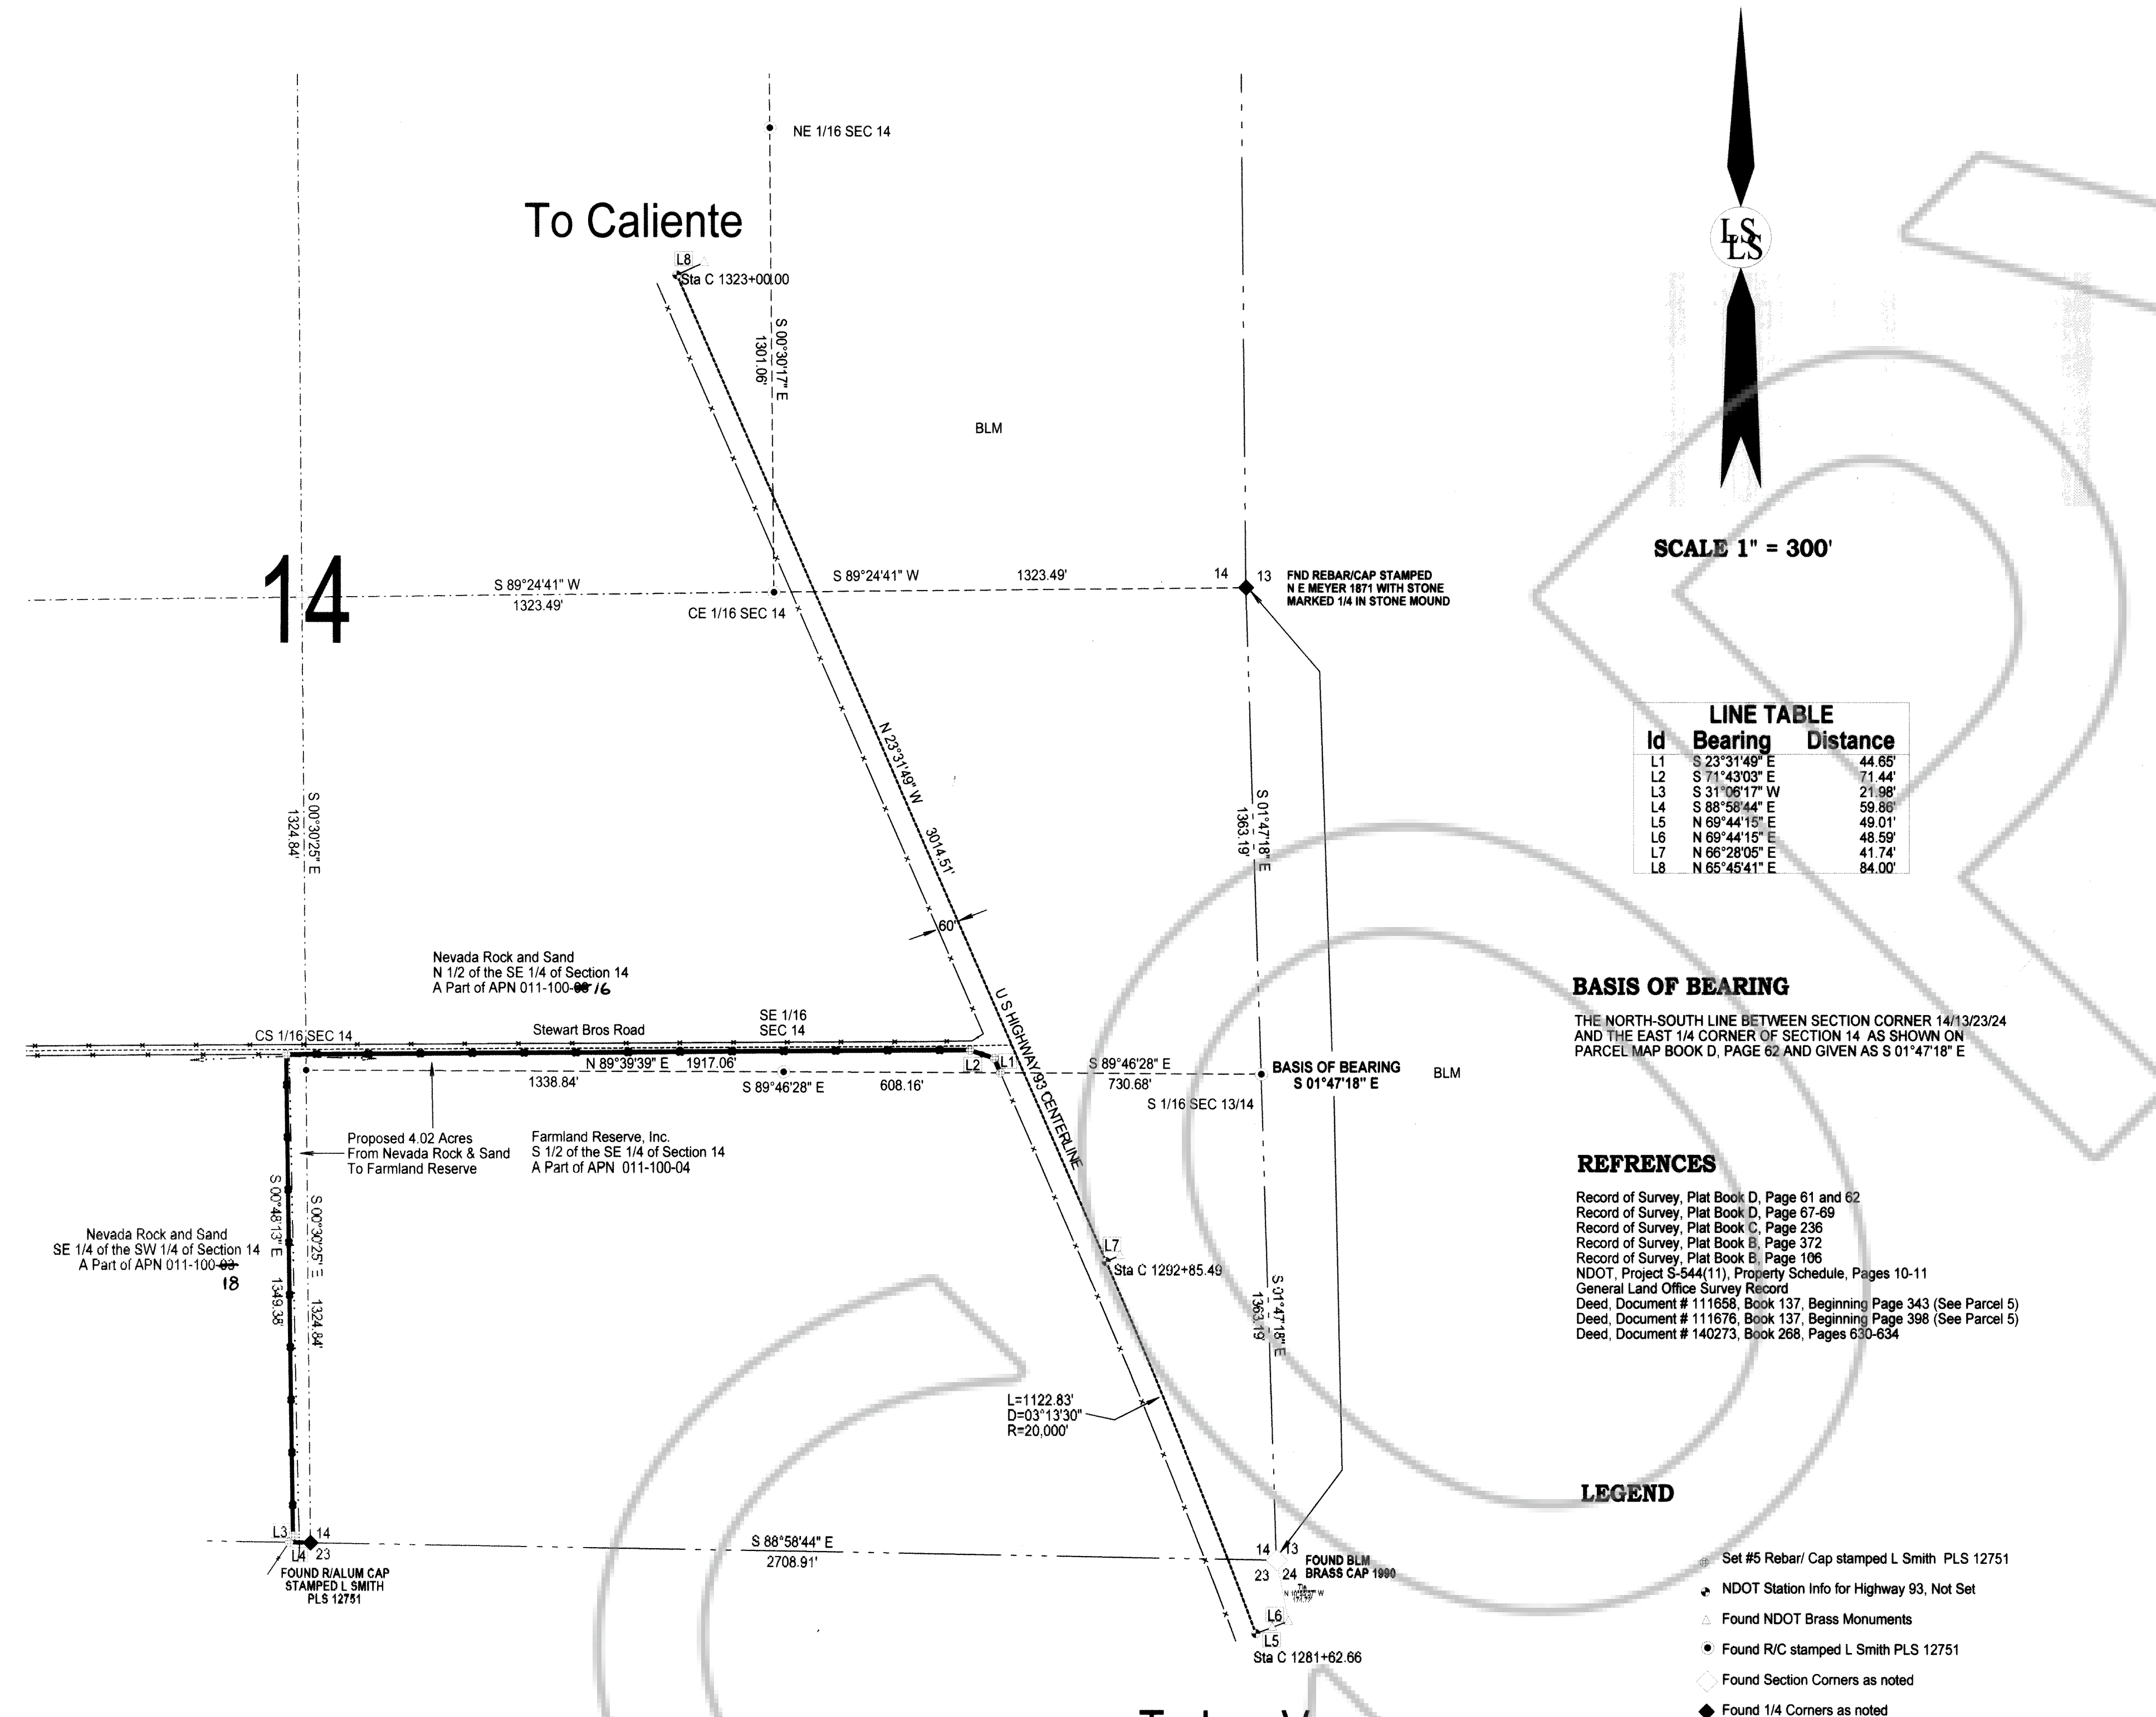

SCALE 1" = 300'

Id	Bearing	Distance
L1	S 23°31'49" E	44.65'
L2	S 71°43'03" E	71.44'
L3	S 31°06'17" W	21.98'
L4	S 89°59'44" E	59.86'
L5	N 69°44'15" E	49.01'
L6	N 69°44'15" E	48.59'
L7	N 65°28'05" E	41.74'
L8	N 65°45'41" E	94.00'

BASIS OF BEARING

THE NORTH-SOUTH LINE BETWEEN SECTION CORNER 14/13/23/24 AND THE EAST 1/4 CORNER OF SECTION 14 AS SHOWN ON PARCEL MAP BOOK D, PAGE 62 AND GIVEN AS S 01°47'18" E

REFERENCES

- Record of Survey, Plat Book D, Page 61 and 62
- Record of Survey, Plat Book D, Page 67-69
- Record of Survey, Plat Book C, Page 236
- Record of Survey, Plat Book B, Page 372
- Record of Survey, Plat Book B, Page 106
- NDOT, Project S-544(11), Property Schedule, Pages 10-11
- General Land Office Survey Record
- Deed, Document # 111656, Book 137, Beginning Page 343 (See Parcel 5)
- Deed, Document # 111676, Book 137, Beginning Page 398 (See Parcel 5)
- Deed, Document # 140273, Book 268, Pages 630-634

LEGEND

- Set #5 Rebar/ Cap stamped L Smith PLS 12751
- ▲ NDOT Station Info for Highway 93, Not Set
- ▲ Found NDOT Brass Monuments
- Found R/C stamped L Smith PLS 12751
- ◇ Found Section Corners as noted
- ◆ Found 1/4 Corners as noted
- ⊕ Center of Section, not set
- Boundary Line Adjustment along existing fence line
- - - Section line
- · - · - Section Center line
- · - · - Highway and road center line
- · - · - Fence
- · - · - Irrigation canal
- · - · - Highway 93 Right of Way and approximate fence line
- · - · - 1/16 line

Description of Boundry Line Adjustment Area

Beginning at the south quarter corner of Section 14, Township 5 South, Range 60 East, of Mount Diablo Meridian at a #5 rebar & 2 1/2" alum cap stamped L SMITH PLS 12751
 Thence N 88°58'44" W 59.86' along the south line of said Section 14 to an existing N-S fence and a #5 rebar & plastic cap stamped L SMITH PLS 12751;
 Thence N 31°06'17" E 21.98' projecting along said fence line to a fence angle point and #5 rebar & plastic cap stamped L SMITH PLS 12751;
 Thence N 00°48'13" W along said fence line 1349.38' to the E-W fence bordering the south side of the Stewart Bros. road to a #5 rebar/plastic cap stamped L SMITH PLS 12751;
 Thence N 89°39'39" E 1917.06' along said Stewart Bros. road south fence line to a fence angle point and #5 rebar/plastic cap stamped L SMITH PLS 12751;
 Thence S 71°43'03" E 71.44' along said fence to the westerly US 93 Highway right-of-way and a #5 rebar/plastic cap stamped L SMITH PLS 12751;
 Thence S 23°31'49" E 44.65' along said highway right of way to the southeast sixteenth line of said Section 14 and #5 rebar/plastic cap stamped L SMITH PLS 12751;
 Thence N 69°46'28" W 608.16' along said 1/16 line to the SE 1/16 corner of said Section 14 and #5 rebar & 2 1/2" alum cap stamped L SMITH PLS 12751;
 Thence N 89°46'28" W 1338.84' continuing along said 1/16 line to the CS 1/16 corner and the N-S center line of said Section 14 and #5 rebar & 2 1/2" alum cap stamped L SMITH PLS 12751;
 Thence S 00°30'25" E 1324.84' on the said center line to the Point of Beginning,
 Containing 4.02 acres more or less.
 The basis of bearings is the east line of the SW1/4 of said Section 14 given as S 01°47'18" E in the Record of Survey recorded on Plat Book D at Pages 61-62 of Lincoln County, Nevada Records.
 End of description.

Boundry Line Adjustment
 For
Nevada Rock and Sand & Farmland Reserve, Inc
 In Section 14, Township 5 South, Range 60 East, Mount Diablo Meridian,
 Lincoln County, Nevada A.P.N. ~~011-100-03~~ and 011-100-04
 011-100-16 & 18
Lenard Smith Land Survey
 509 Main Street
 P.O. Box 443
 Caliente, Nevada 89008
 Phone/Fax 775 726 3365
 Cell Phone 775 962 1196
 Sheet 1 of 1