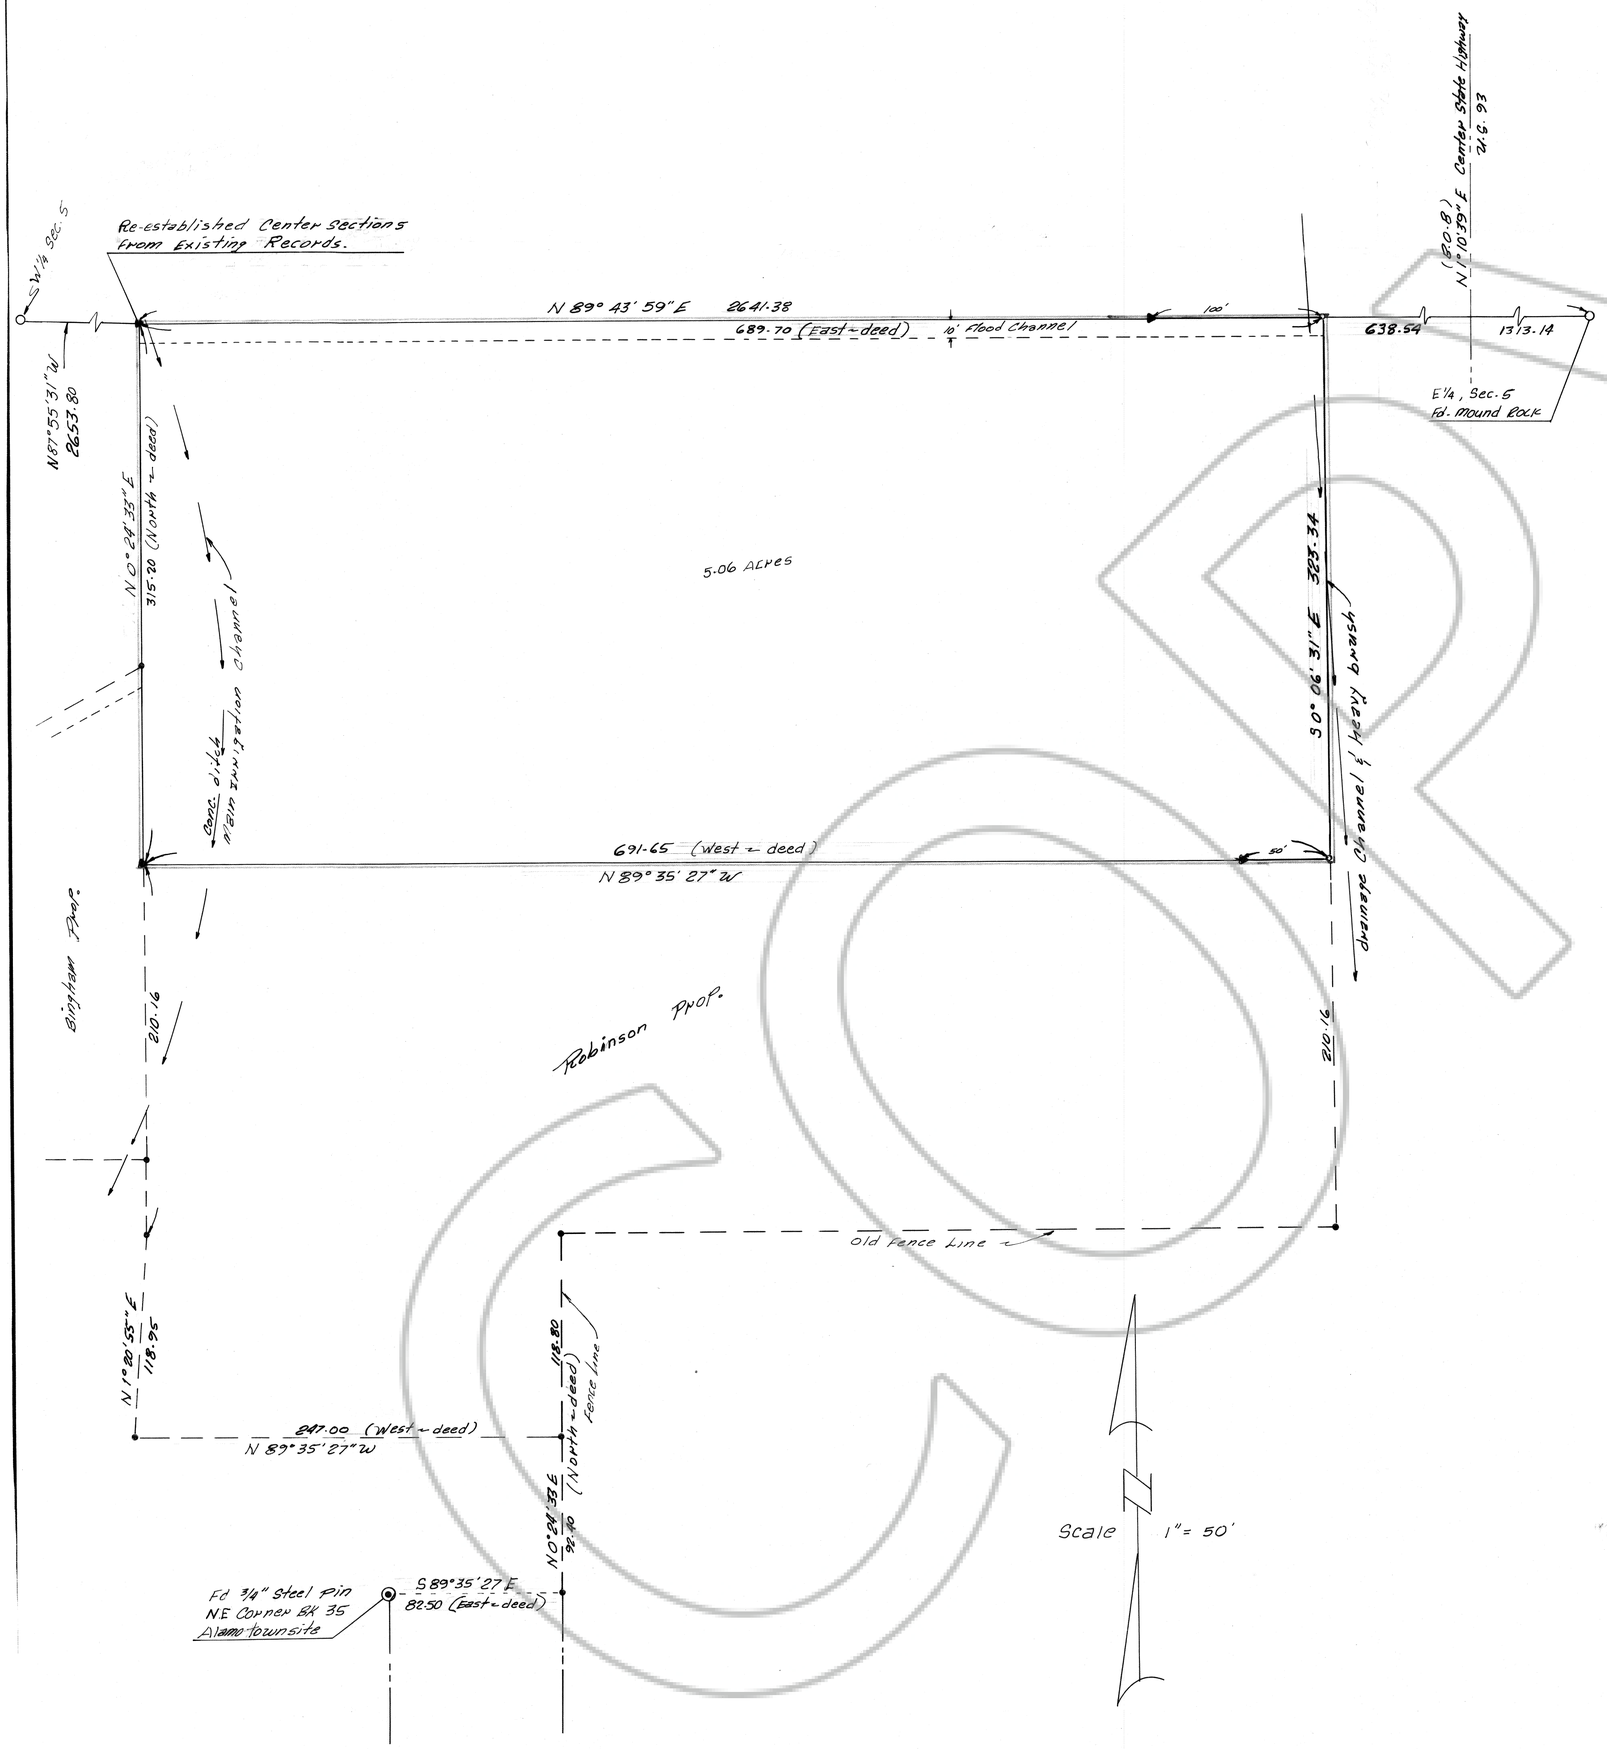

Surveyor's Certificate

I -- Dennis H. Wise a duly registered Land Surveyor in the State of Nevada hereby Certify that this map accurately delineates a survey made under my supervision and completed the 10 day of Feb. 1975 and that the Points set and the Points found are correctly shown hereon this Survey was completed at the instance of Willis Walch.

Dennis H. Wise
Dennis H. Wise
Nevada Certificate n: 2379

REGISTERED LAND SURVEYOR · STATE OF NEVADA
DENNIS H. WISE
NO. 2379

Basis of Bearing

N 1° 10' 39" E being the Center line of Highway U.S. 93 from Station "C" 748+91.4 P.T. to Station "C" 784+00.0 P.O.T. Project S 554 (0) Sheet # 28 State Highway plans.

Legal Description

Commencing at the North West (NE) Corner of Blk 35 Alamo townsite in Section 5 township 7 South, Range 61 East, M.D.B. & M., thence S 89°35'27"E 82.50 feet to a Point; thence N 0°24'33"E 92.40 feet to a Point; thence N 89°35'27"W 247.00 feet to a point; thence North 1° 20' 55" East 118.95 feet to a Point; thence N 0°24'33"E 210.16 feet to a point being the NW Corner of Robinson property being the true point of Beginning thence N 0°24'33"E 315.20 feet to the Center of Section 5 Re-established from Existing Records; thence N 89° 43' 59" E 689.70 feet to a point; thence S 0°06'31" E 323.34 feet to a point being the NE Corner of Robinson property described in document No. Lincoln County Records; thence N 89°35'27"W along the North Line of said Robinson property a distance of 691.65 feet to the True Point of Beginning.

Legend

- Fd. ½" Rebar
- Set ¾" Rebar

RECORD SURVEY
for
Willis Walch

Portion of Sec. 5, T 7 S, R 61 E
Lincoln County, Nevada

Scale 1" = 50' | Date February 10, 1975

No. _____
Recorded at the request of
CHICAGO TITLE INS. Co.
Date 4/25/75 at 1:01 P.M.
File PLAT-A Page 113
of Surveys
Official Records Book _____
Lincoln County Nevada Recorder
Recorder
Fee $ 2.50 G. Lee Deputy